


KEY:
 Stormwater ———
 Foul Sewer ———
 Water Main ———
 Water Toby ■

NOTE: All Mudtank leads
 225mm dia
 uPVC

ORIGINAL SIZE A3
 0 10 20 30 40 50 60 70 80 90 100
 DO NOT SCALE - IF IN DOUBT, ASK

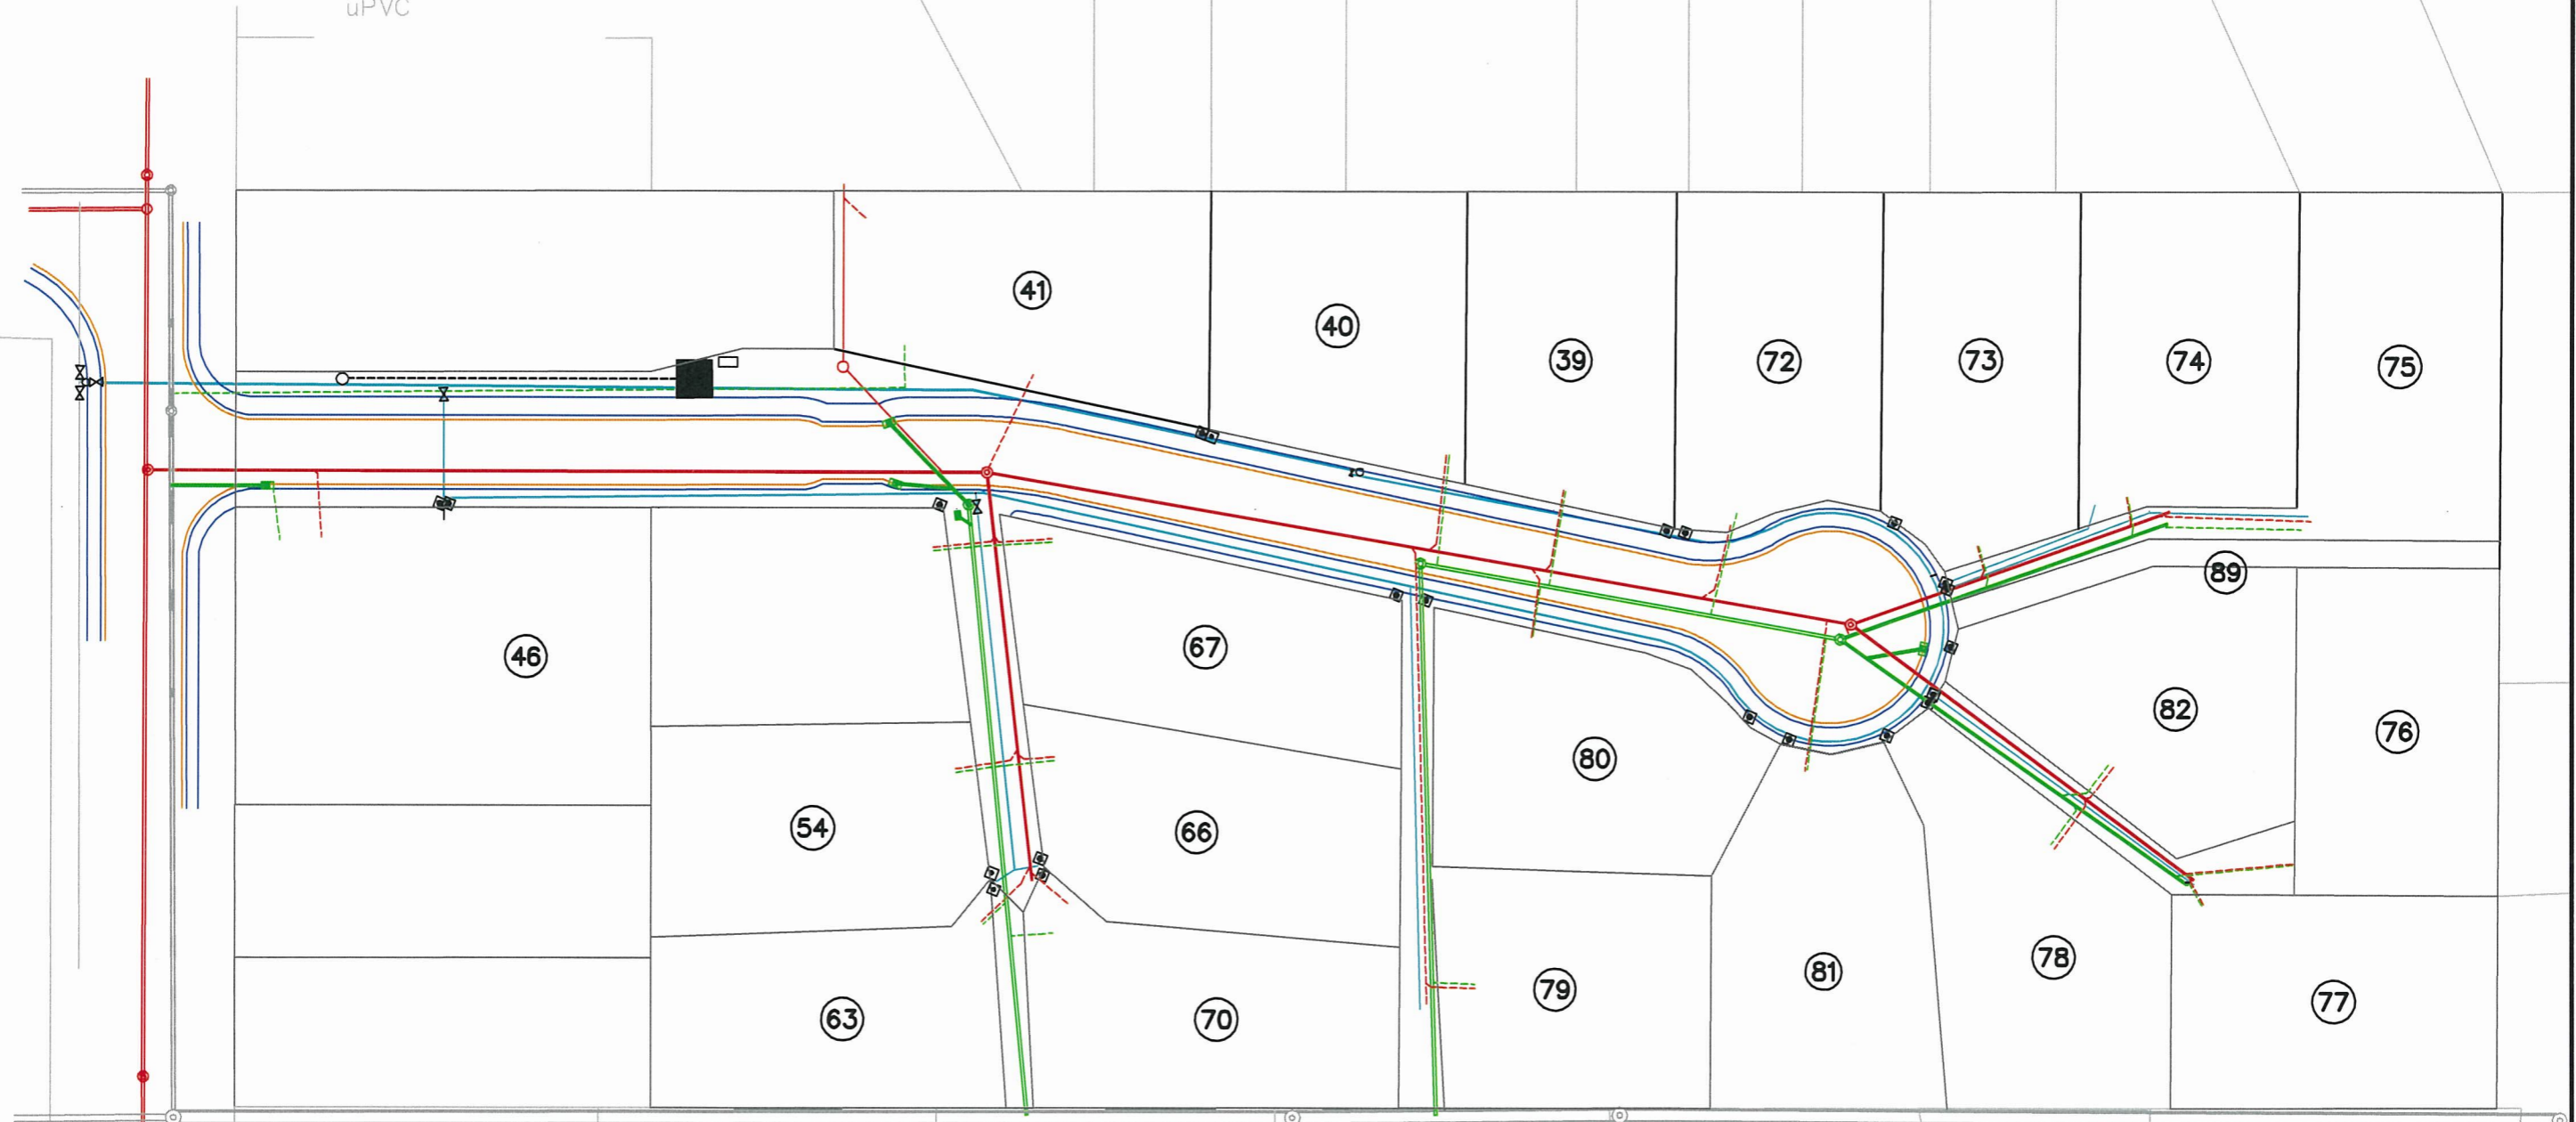

1200mm Ø RCRRJ
 L=122.97m S=1:1117.92

1200mm Ø RCRRJ
 L=103.37m S=1:434.78

File Ref:

Prepared For:

No.	Amendments	Drawn	Date

TAB/DWG :
 SERVER : DUNEDIN (OCTAGON_D)
 XREFS :
 COPYRIGHT ©
 These drawings shall only be used for the purpose for which they were supplied.
 Any re-use is prohibited and no part of this document may be reproduced or distributed without the written permission of TL Survey Services LTD.

AS-BUILT DRAWING MOSGIEL

ENGINEERING SPECIFICATION
 FOUL SEWER, STORM WATER, WATER RETIC

Project No.: 06148	Surveyed: DPJ
Scale: 1:750	Designed: DPJ
Date: APRIL 2007	Drawn: DPJ
Sheet: 10 OF 12	Checked: JRP

